

RARE OPPORTUNITY FOR FREE
BRANDING & ADVERTISEMENT

TENANT BRAND BUSINESSCENTER

*The future Home of **Your Brand** including headquarter
offices, sales and services*

INTRODUCTION

Exposure & Visibility

Alea Properties is pleased to present the opportunity to the future tenants to showcase it's brand as BUILDING SIGNAGE to 28 saddle drive Woodmead (N1 Highway and R5) to **Your Brand**.

Your Brand BUSSINESS CENTER is highly visible on N1 highway and R55 /woodmead drive, Sandton. Traffic counts in front of the **Your Brand** BUSINESS CENTER are excellent with over **200,000** vehicles *passing* the site *per day*.

Your Brand Business Center is located in woodmead Office park ideally located in the heart of woodmead.

Your Brand business Center located in prime location with Tremendous N1 and R55 highway exposure- close on 150 meters of wrap around frontage onto the N1 and woodmead Drive.

Security: the park has Fantastic security controls and the park features controlled access and vigilant guards patrolling 24/7. The office park is filled with mature gardens and scenic walking routes.

Natural lights: all space have windows.

Accessible from the N1 highway to woodmead drive /R55 and M1 highway using woodmead off - ramp.

NOTE:

"Your Brand" : provide promotion or advertising opportunity to the Future ANCHOR TENANT to write, COMPANY NAME ,BRAND NAME OR LOGO.

"Signage" is branding opportunity of tenant products or services to N1 highway.



28 saddle prime location,
Value for money secure ,modern and elegant style.

SUPERBLY SITUATED AT THE GATEWAY TO All South Africans amongst provinces such as Gauteng.



A

A state of the art with bold facade N1 frontage making stand out from the rest and offer great views from N1 highway as well as quality finishes throughout.



B

Your Brand signage will be viewed with over 200,000 vehicles passing the site per day.



TENANT SIGNAGE

C

Three Main Building
Entries.

D

Open space for tenant and employees during break hours.



E

Open space close up view for the tenants and employs with a mature garden.

Free balconies can be used by employees or other purposes i.e. entertainment etc.

NB: *Your Brand* will be painted along the windows (if need be) red will be removed if not resonate with your branding.



F

Available parking: Basement, Covered & Open parking.
Nearby visibility & view of companies and headquarters
of **ORACLE, FORD FURY, Cell C, Mall of Africa,**
Holiday Inn & FLUOR. Etc.



G

The office park is prestigious with air of tranquility. The gentle ambience is created by the large open landscape space, game park.

H & I

H: An additional boom and security guard house.


I: Balcony.





J

Main lobby with an attractive high ceiling up to the 2nd Floor..

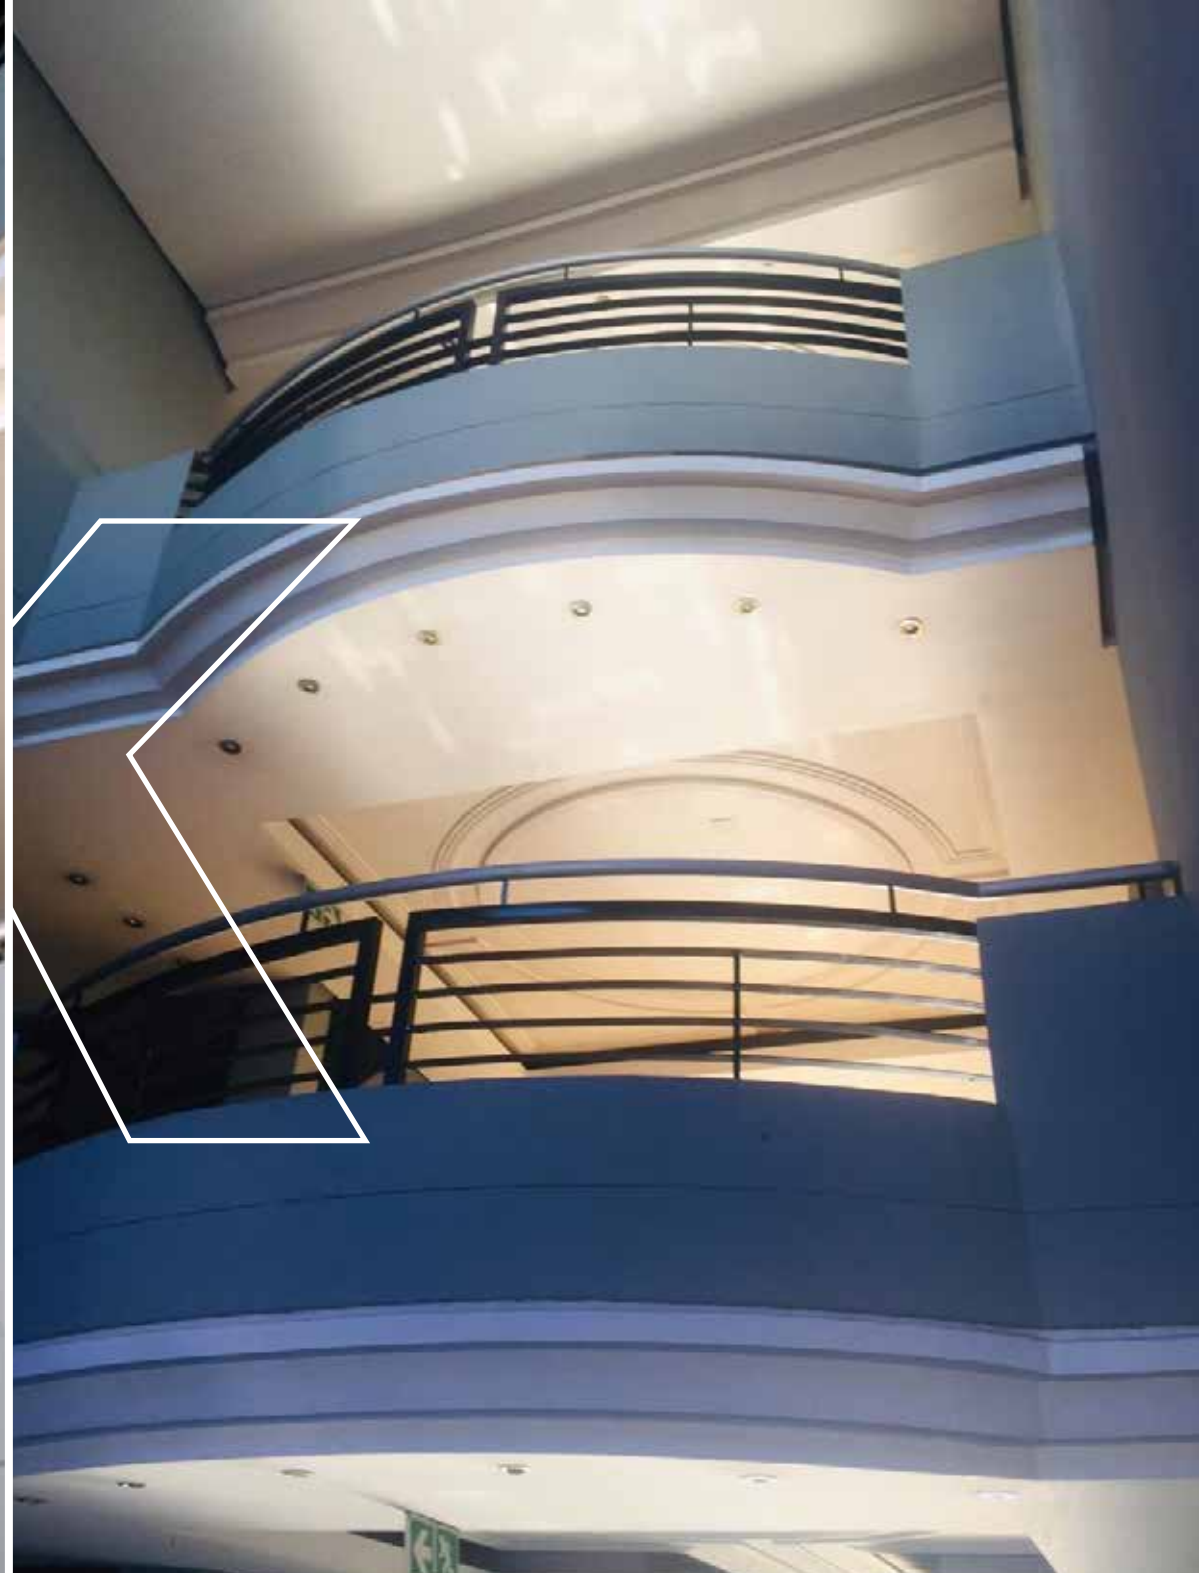

K

Main lobby with an attractive high ceiling.



L

Ground floor.

The building consists of 3 levels (Parking basement, ground , first & second)with a lift in the building for wheelchair accessibility and easy of access (from parking or ground)



M

Modern lobby 1st and 2nd floor leading to your office.




N

The space will be finished with top quality finishes that are incredibly neat and has balconies available for free. Office open plan office ample natural lightflow throughout and spectacular of the office park's beautiful gardens.

FLOOR PLANS

Floor plan to be designed according to tenant configuration use.

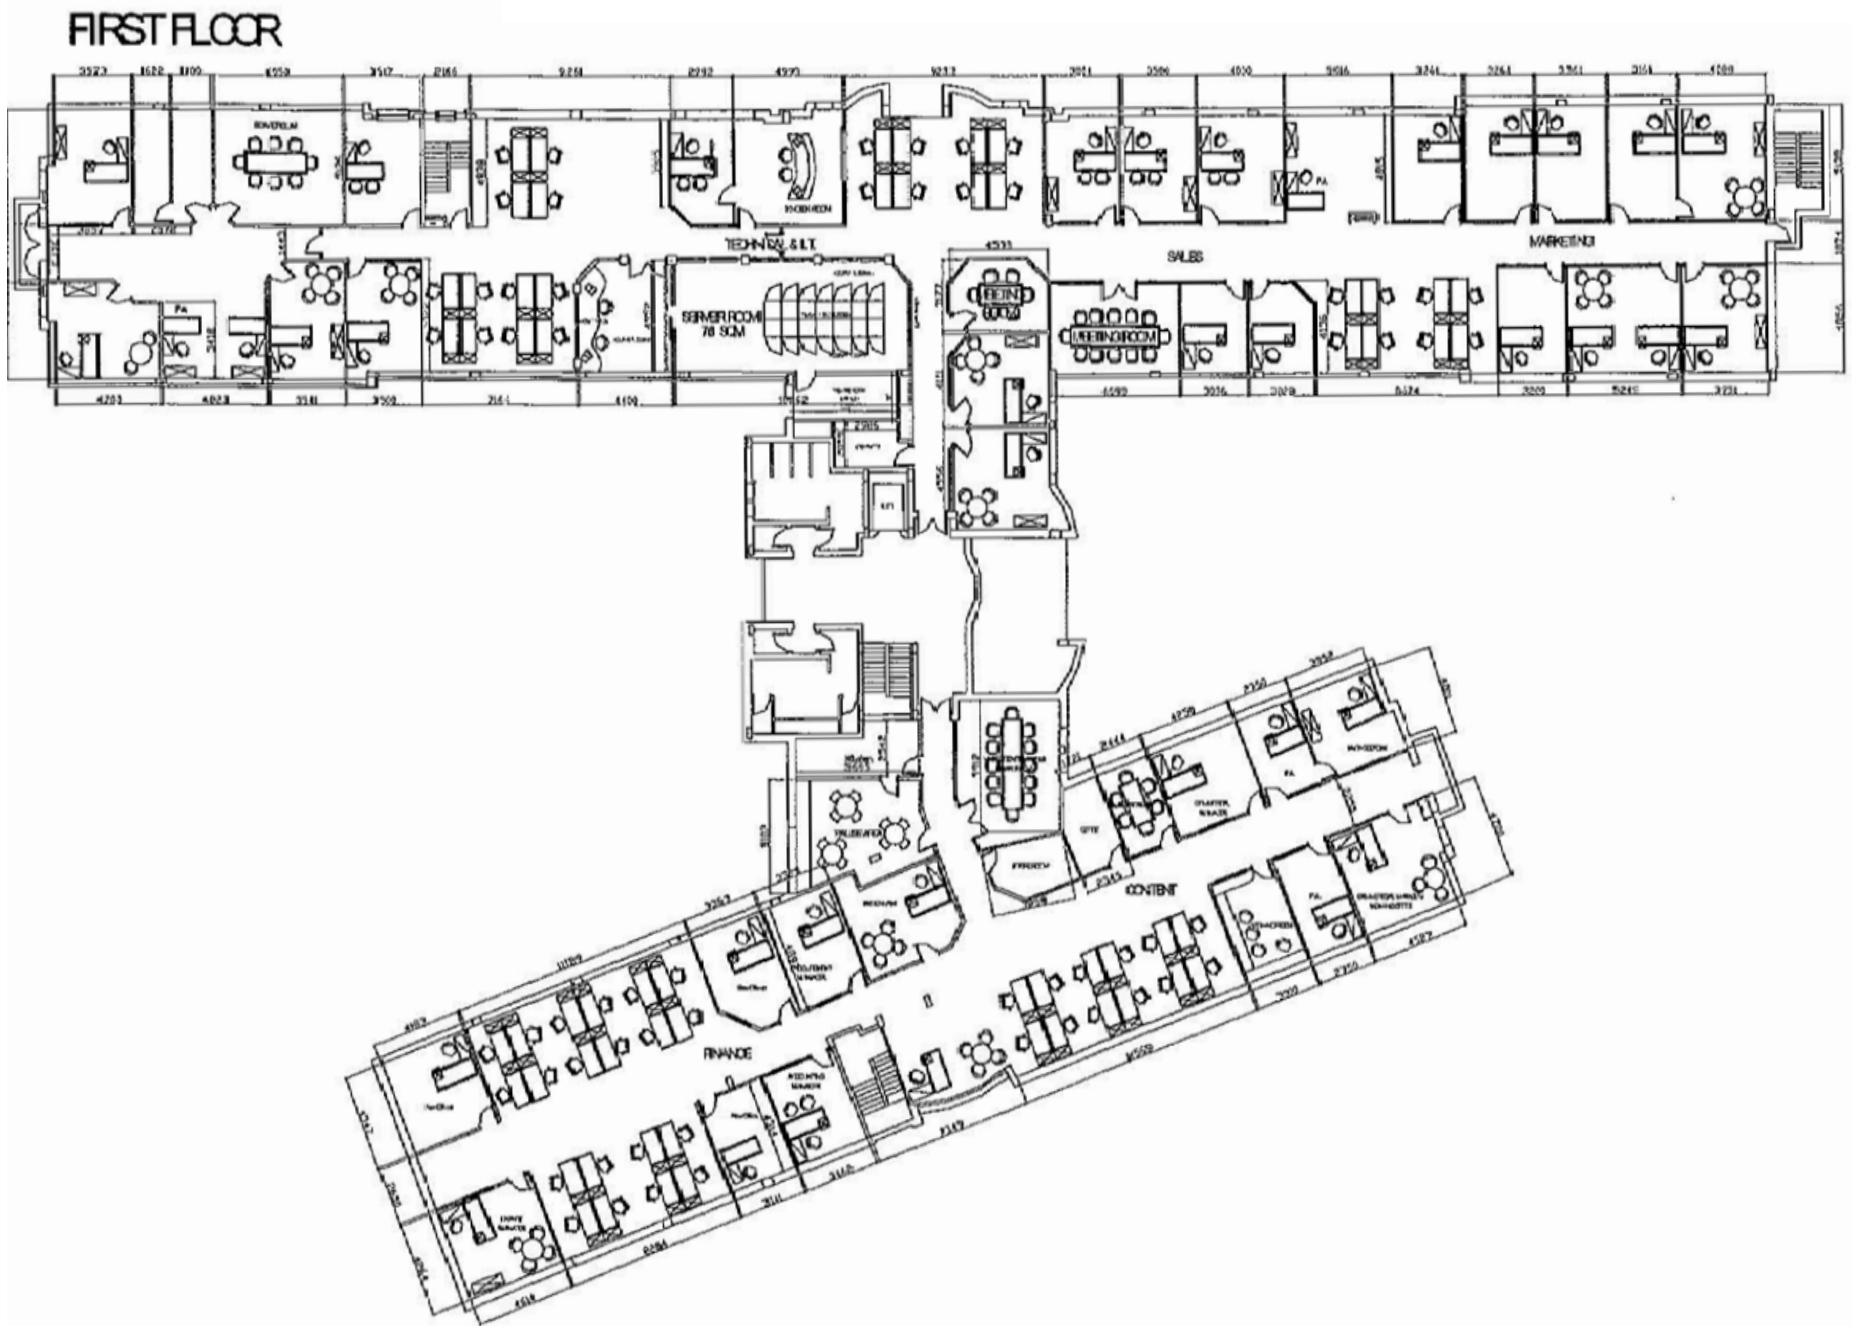

Bel Geddes DESIGN ARCHITECTS, INTERIOR DESIGNERS, FACILITIES PLANNING CONSULTANTS TEL: 805-2005 P.O. BOX 1017 FAX: 805-3487 PINEGROVE email: info@belgeddes.co.za 2123	DRAWINGS MUST NOT BE SCALED. DIMENSIONAL DIMENSIONS MAY ONLY BE USED. DIMENSIONS SHOULD BE VERIFIED ON SITE AND ANY DISCREPANCIES REPORTED IMMEDIATELY. THIS DRAWING IS A COPYRIGHT AND REMAINS THE PROPERTY OF BEL GEDDES DESIGN CO AT ALL TIMES.	NOTES		REV	DATE	DESCRIPTION	 ISSUED FOR INFORMATION	ODM		DRAWING NUMBER GGV1820	R/N 00	SHEET 01
		LEGEND										

0


FIRST FLOOR (as built drawing/plan)

GLA 1,844 M2
South Wing 684m2
North wing =1160M2
Common area excluded

Samples of floor plan/plates/shape.

NOTE: GLA = Gross leaseable area

P

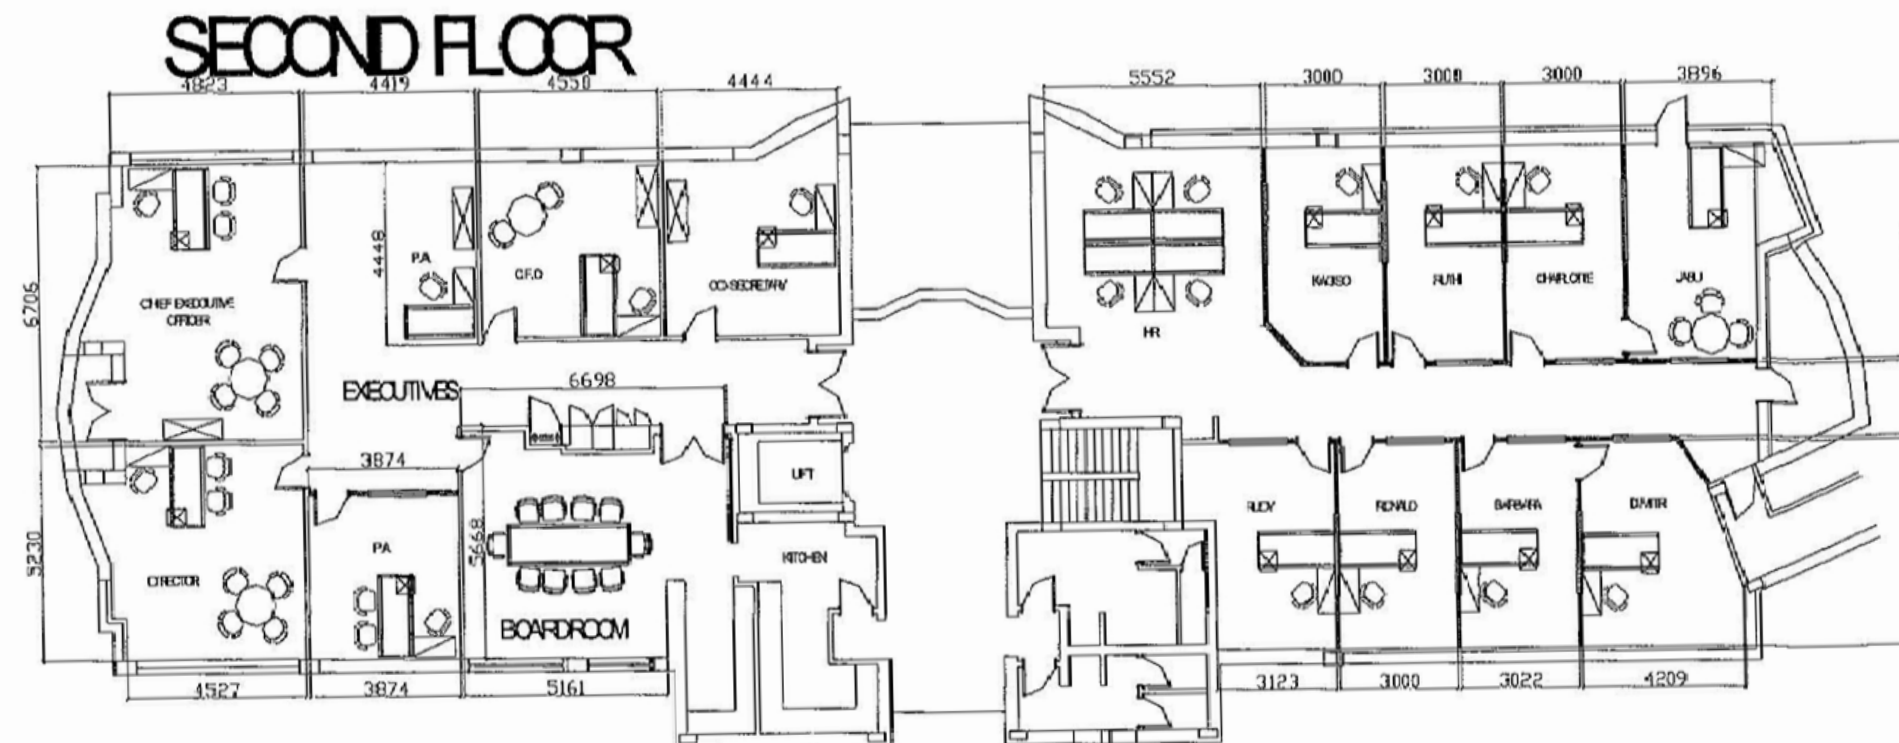


Bel Geddes DESIGN ARCHITECTS, INTERIOR DESIGNERS, FACILITIES PLANNING CONSULTANTS TEL: 800-2803 P.O. BOX 1612 FAX: 800-2487 PINEGROVES email: info@belgeddes.co.za 2129	NOTES		REV	DATE	DESCRIPTION	ODM JWB:ND DATE: 2010 SCALE: 1:500 DATE: 2010 SCALE: 1:500 DATE: 2010 SCALE: 1:500	00 01
	LEGEND						

P

SECOND FLOOR
(as built drawing/plan)

GLA 458m2
Can be divided in two suite A&B
Suite 2A...229M2
Suite 2B...229m2
Neat and ready to be occupied.

GROUND FLOOR

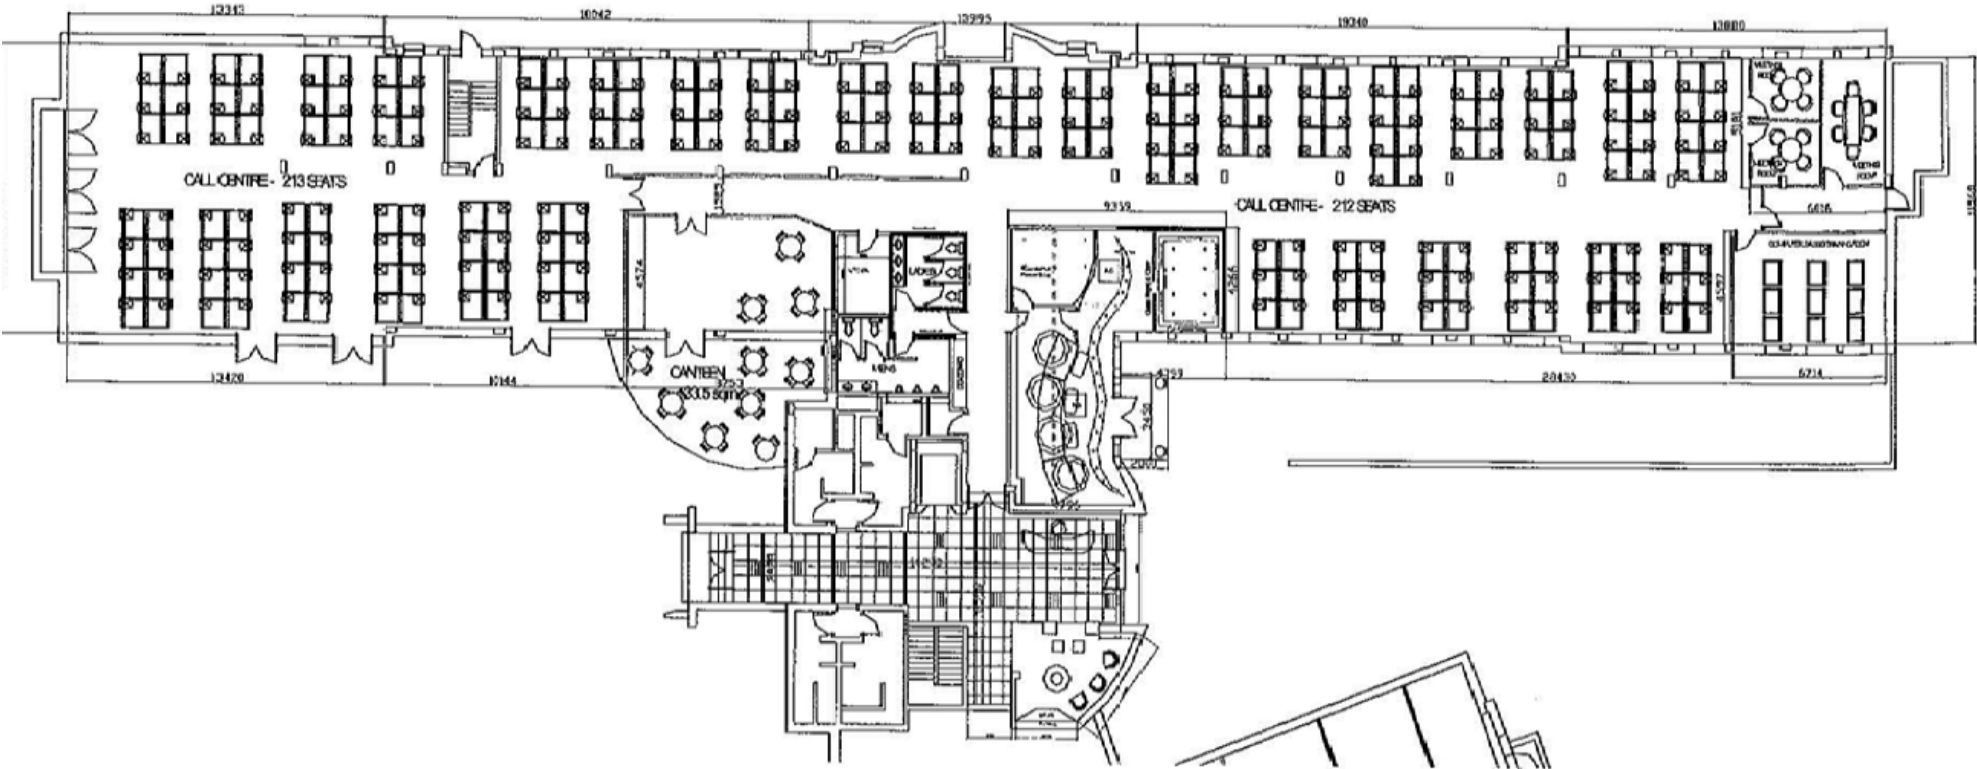

Q

GROUND FLOOR
(as built drawing/plan)

TOTAL GLA Is 1844 m2
South wing =684m2
North wing =1160
Common area excluded

NOTE : Ground floor layout is not complete floor (for complete floor please refer 1st floor shape / plate).

Bel Geddes
DESIGN
ARCHITECTS, INTERIOR DESIGNERS,
FACILITIES PLANNING CONSULTANTS

TEL: 805-2665 P O BOX 1917
FAX: 805-3487 PINEGONYE
email: studio@belgeddes.co.za 2123


DRAWINGS MUST NOT BE REPRODUCED, COPIED OR DIMENSIONS MAY ONLY BE USED. DIMENSIONS SHOULD BE VERIFIED ON SITE AND ANY DISCREPANCIES REPORTED IMMEDIATELY. THIS DRAWING HAS A COPYRIGHT AND REMAINS THE PROPERTY OF BEL GEDDES DESIGN CO AT ALL TIMES

NOTES		REV	DATE	DESCRIPTION
LEGEND				

 **ISSUED FOR INFORMATION**

ODM	
JOB NO	SCALE
DRAWN: L.N.1	DRAWN: NAME
DATE: 04/07/18	BY: (signature)
DRAWING DESCRIPTION	

GROUP/LEADER	REF	SHEET
ODM 00012	00	01

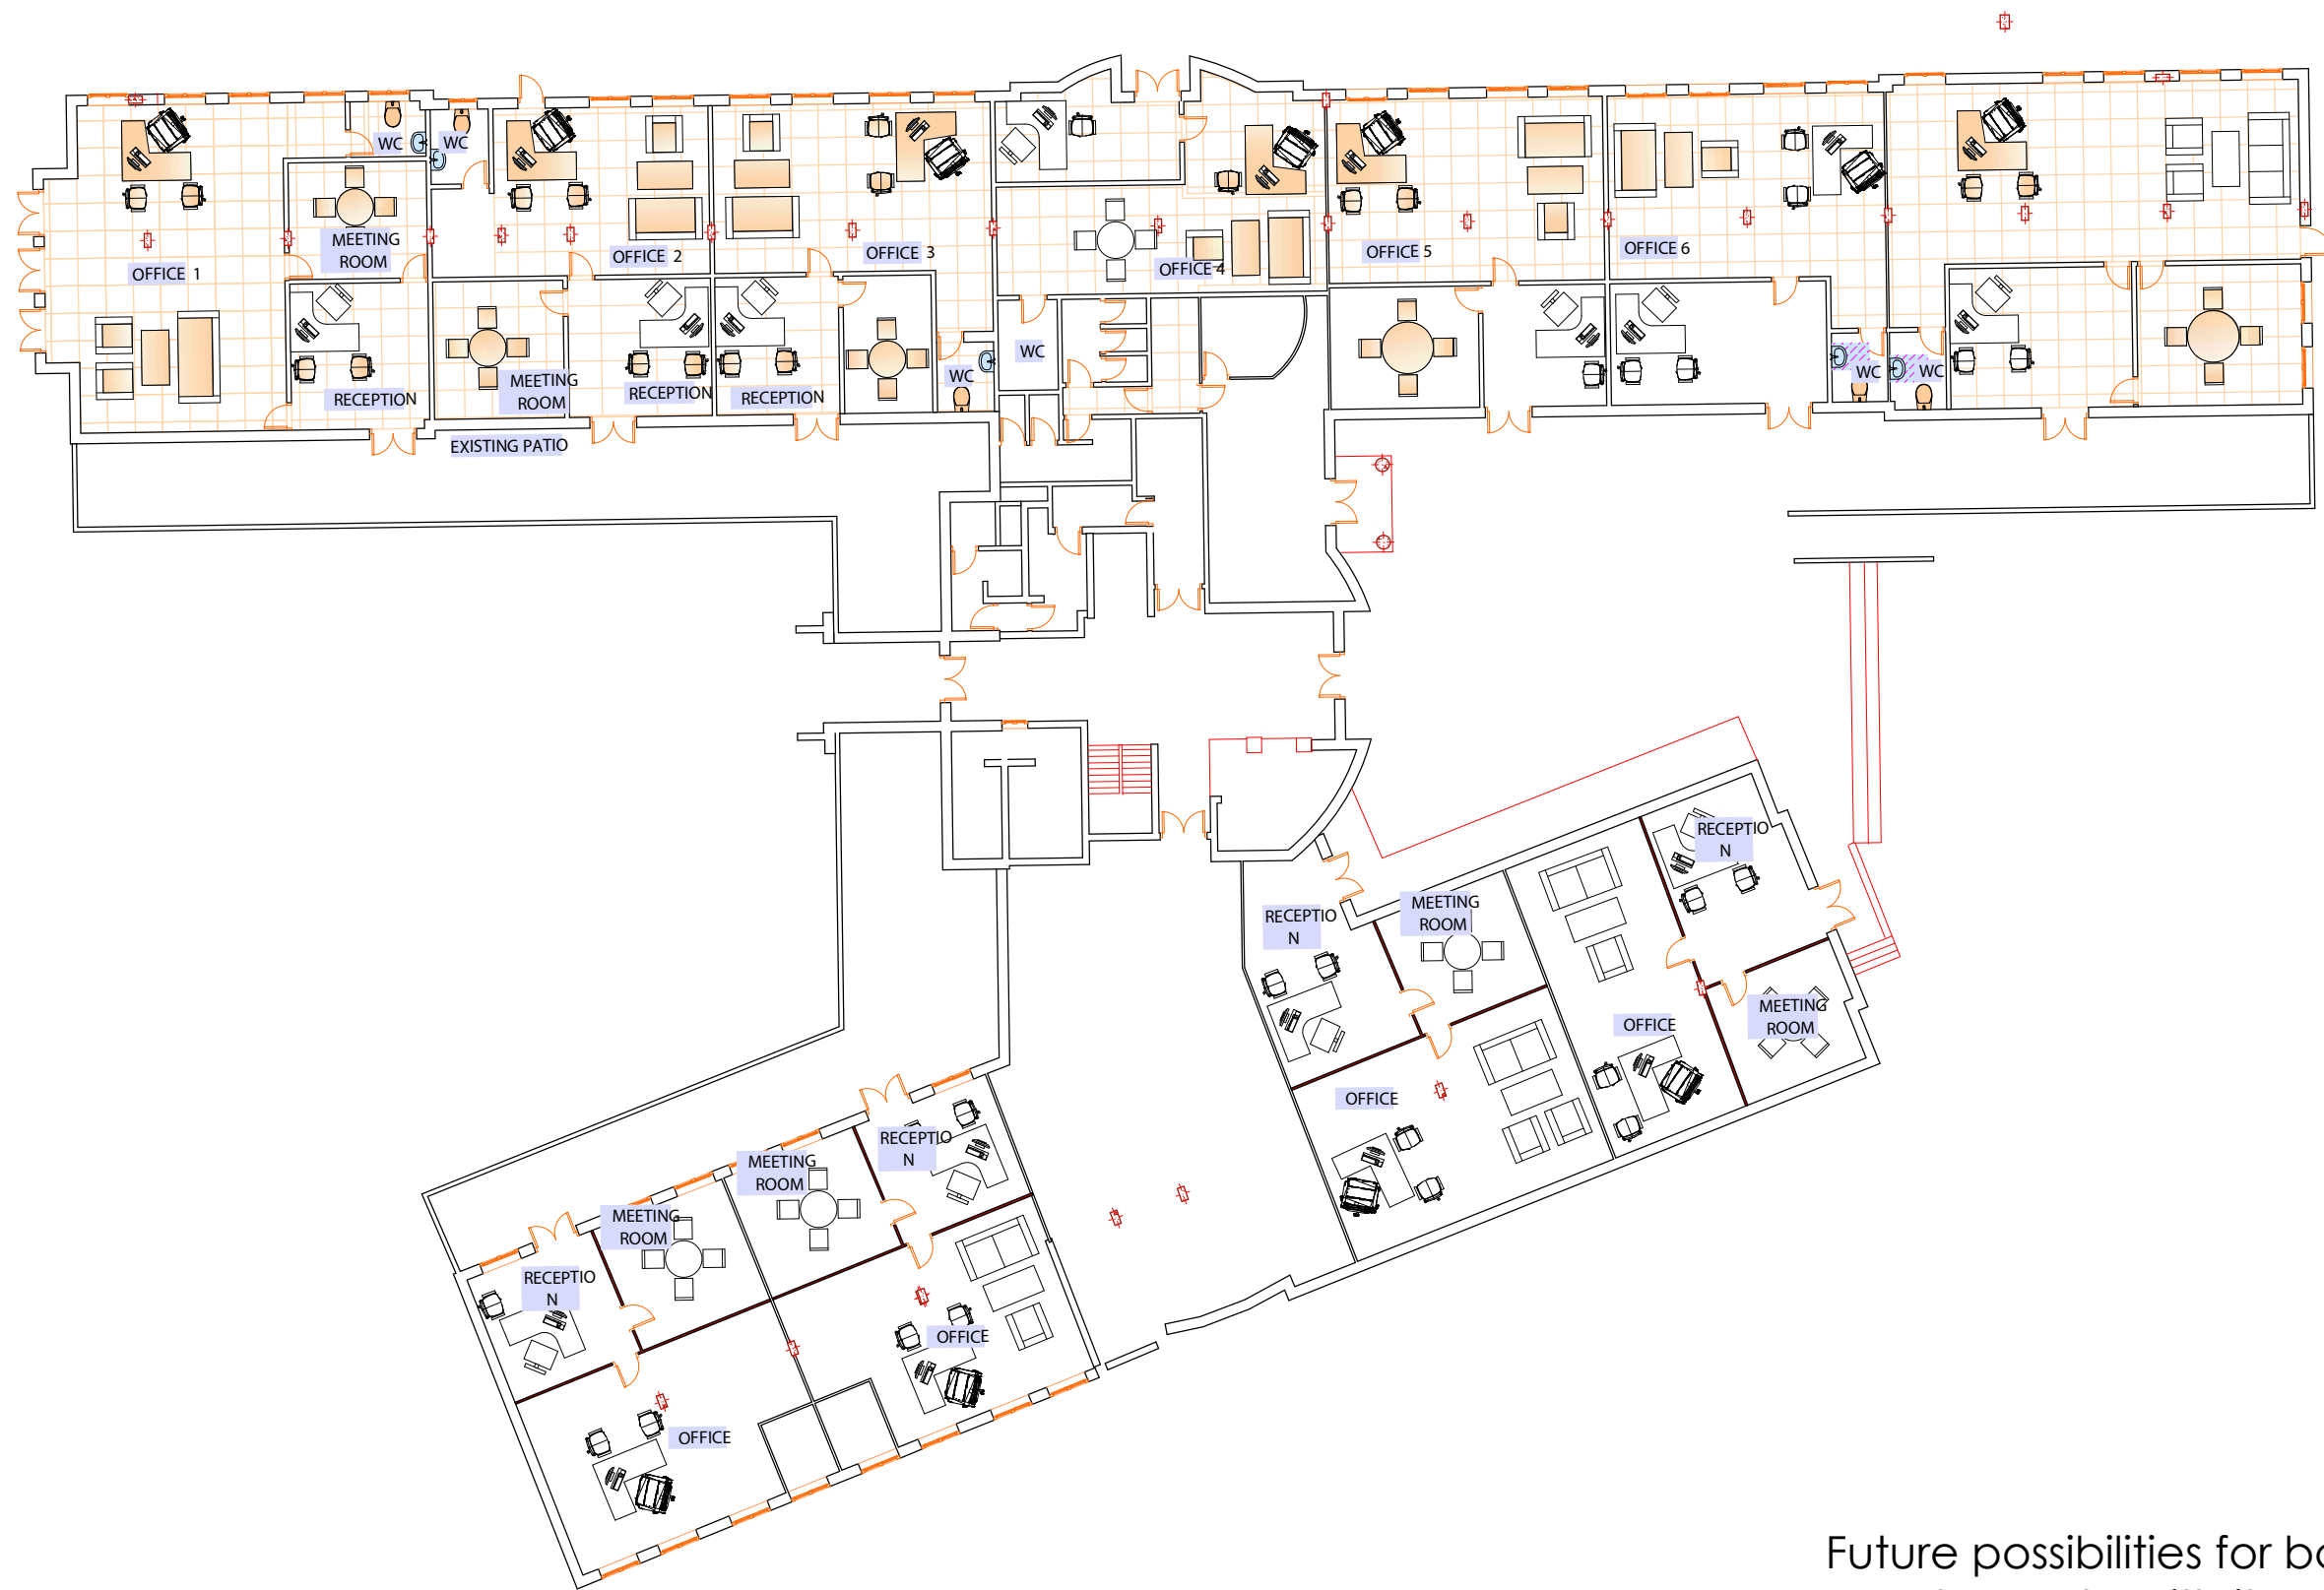

Future possibilities for batique office condos.
each condo with its own restroom / toilet .

Alea Properties and its leasing affiliates use location intelligence and combination of powerful software and detailed analysis to choose best demographics data in their respective area.
Our moto is help our tenant to succeed.

OUR TENANTS (SA)

PANDROL SOUTH AFRICA, Wirtgen, CFAO group, PRIMEDIA,
JC DECAUX SOUTH AFRICA PTY LTD

ELLEN EDWARD
MANAGING DIRECTOR (GLOBAL)
Acquisitions.Leaseing.Disposition
M: **+1 615 878 3098**
ellen@alea**properties**.com

MAPHIOS MAWERE
PROPERTY MANAGER
South Africa (Office)
M: **+27 (72) 970-9617**
maweremaphios@yahoo.**com**

**OFFICE SA) : 28 Saddle Drive, Woodmead,
Sandton, Johannesburg South Africa**

Prepared & Presented by:
Alea properties family of companies.



www.alea**properties**.com